



North West Elevation

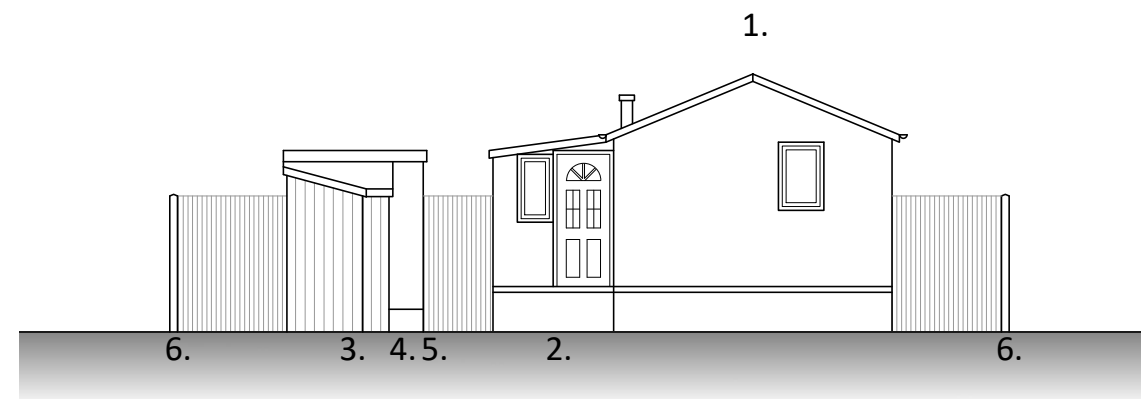


South East Elevation

1. Mobile Home
2. Site Built Porch
3. Gardening Shed
4. Tool Store
5. Study
6. 1.8m high close board fence panels set in concrete fence posts

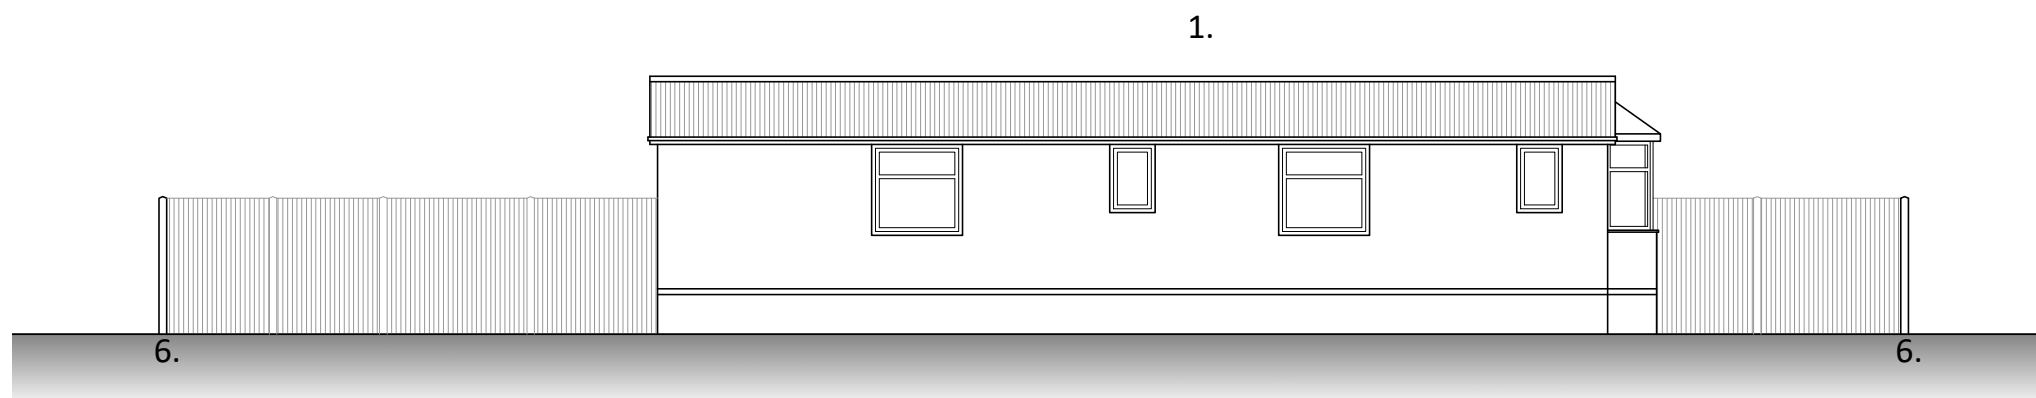

North East Elevation

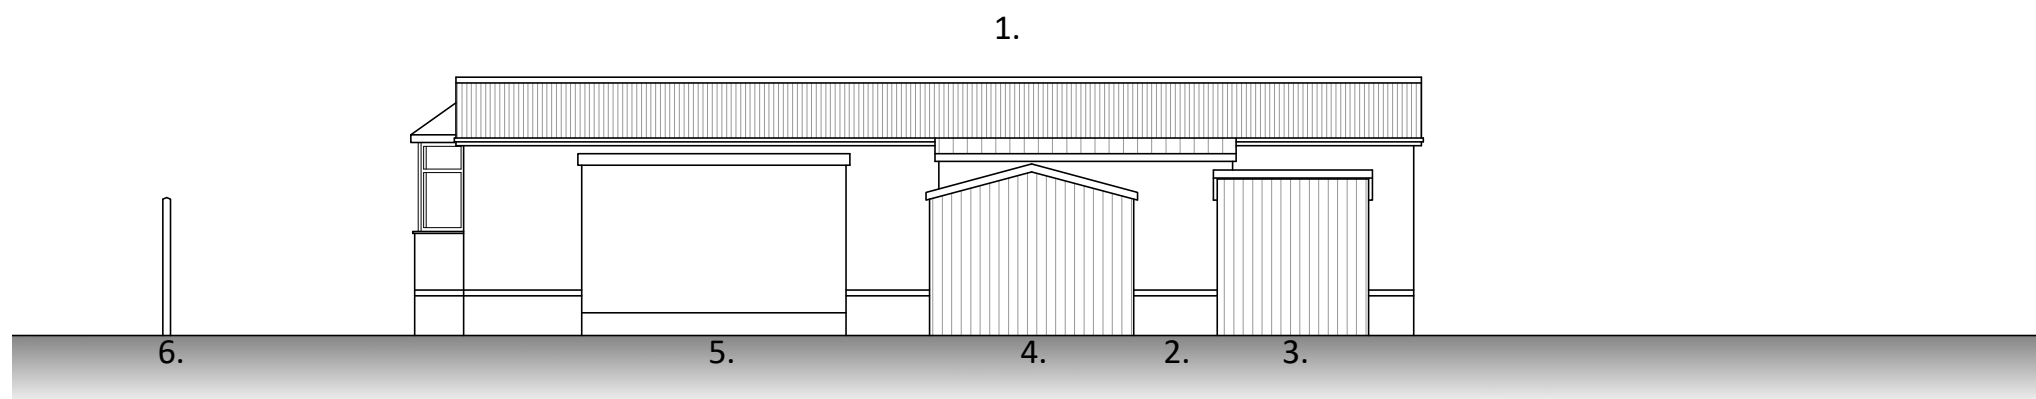

South West Elevation



project title
Brookfield Farm - Mobile Home
For: AJM Planning Associates

drawing title
As Built Elevations

job no.	work stage	drawing no.	rev
0262	WS1	025	A

scale	date
1:100 @ A3	March 2020

purpose
Record / Reference

