




COPYRIGHT RESERVED. THIS DRAWING MAY NOT BE USED OR REPRODUCED WITHOUT WRITTEN CONSENT. COPYRIGHT DESIGNS AND PATENTS ACT 1988.

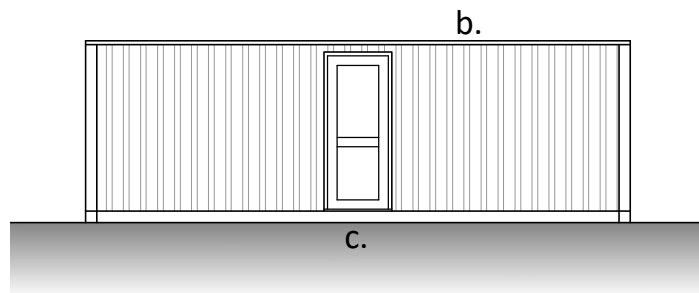


North East Elevation

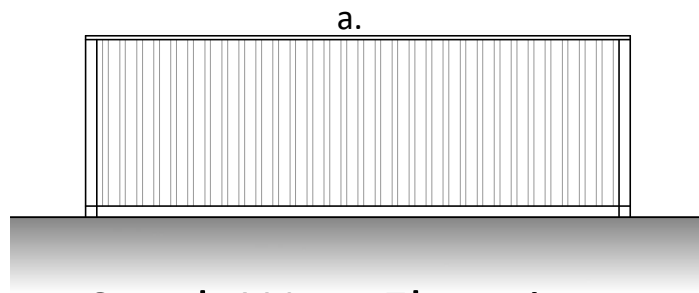

South West Elevation  
Also Elevations Between Containers

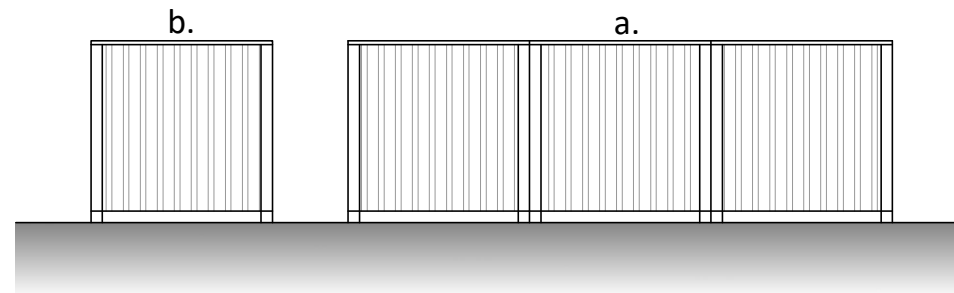

North West Elevation


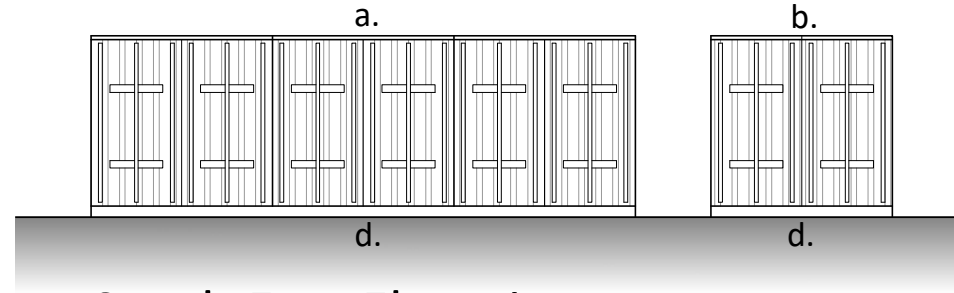


South East Elevation

rev

date drawn ch'k'd

- a. Containers 1-3
- b. Container 4
- c. Personnel Door into Container 4
- d. General Access to all Containers

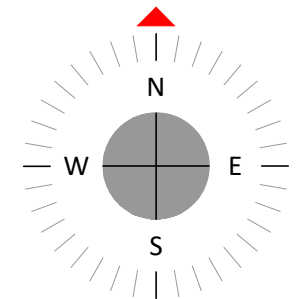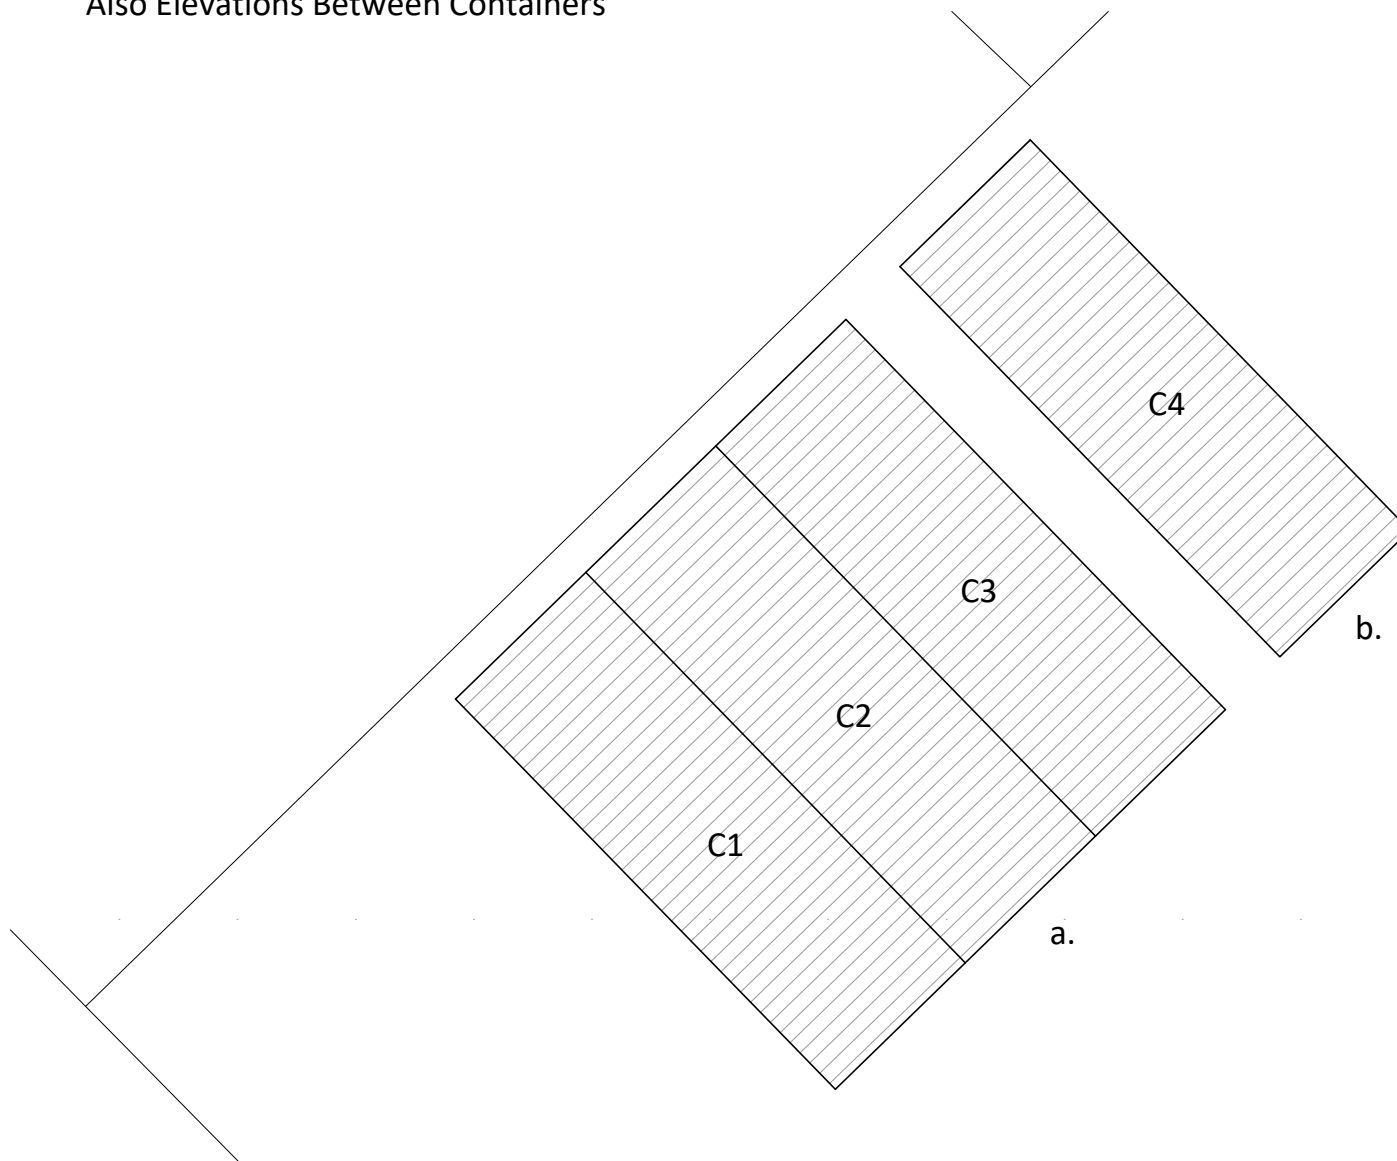

project title  
Brookfield Farm - Containers  
For: AJM Planning Associates

drawing title  
As Built Plan & Elevations

job no.	work stage	drawing no.	rev
0173	WS1	020	

scale	date
1:100 @ A3	March 2020

purpose  
Record / Reference

