



COPYRIGHT RESERVED. THIS DRAWING MAY NOT BE USED OR REPRODUCED WITHOUT WRITTEN CONSENT. COPYRIGHT DESIGNS AND PATENTS ACT 1988.

rev	date	drawn	ch'k'd
A	02/04/20	SGP	
Survey amendments			

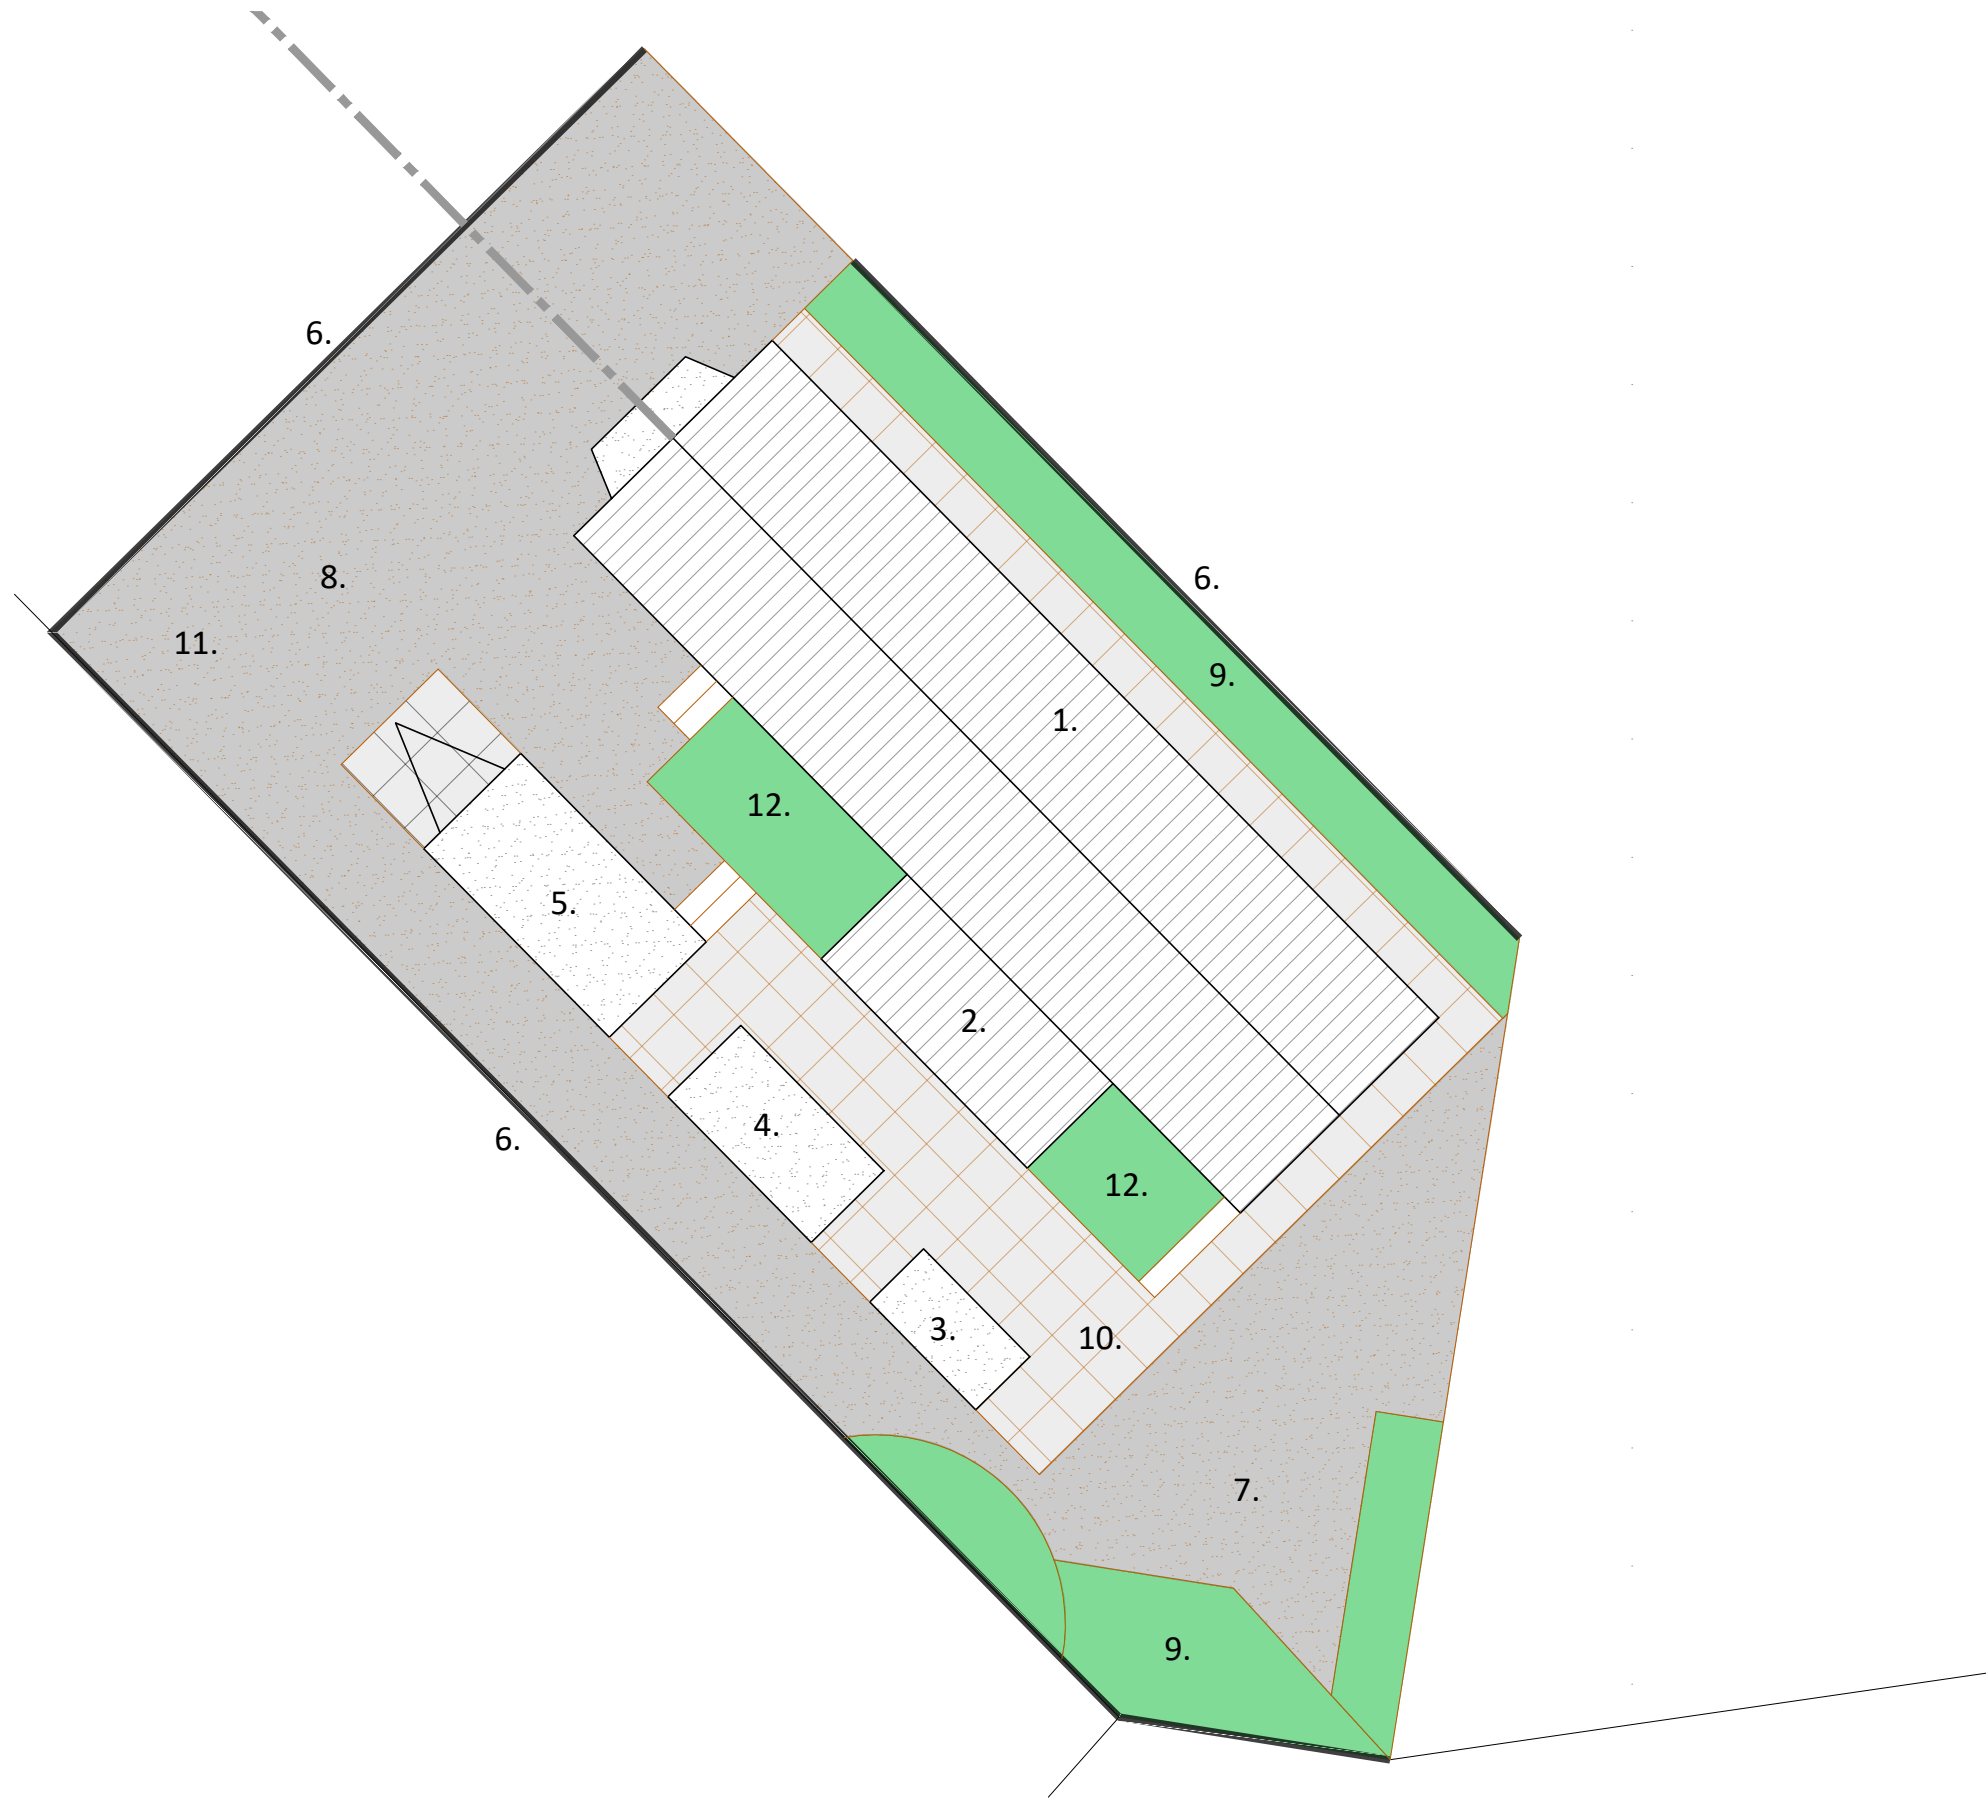

1. Mobile Home
2. Site Built Porch
3. Gardening Shed
4. Tool Store
5. Study
6. 1.8m high close board fence panels set in concrete fence posts
7. Parking - Car
8. Parking - Camper Van
9. Soft Landscaping
10. Hard Landscaping - Paving
11. Hard Landscaping - Gravel
12. Hard Landscaping - Timber Decking with artificial turf covering.

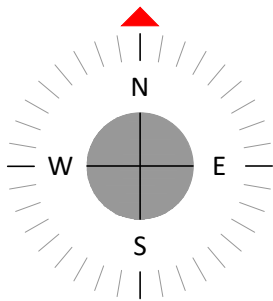

project title				Chartered Practice
Brookfield Farm - Mobile Home				
For: AJM Planning Associates				
drawing title				
As Built Plan				
job no.		work stage		drawing no.
0262		WS1		020
				rev
scale		date		
1:100 @ A3		March 2020		
purpose				
Record / Reference				